




new concrete pad

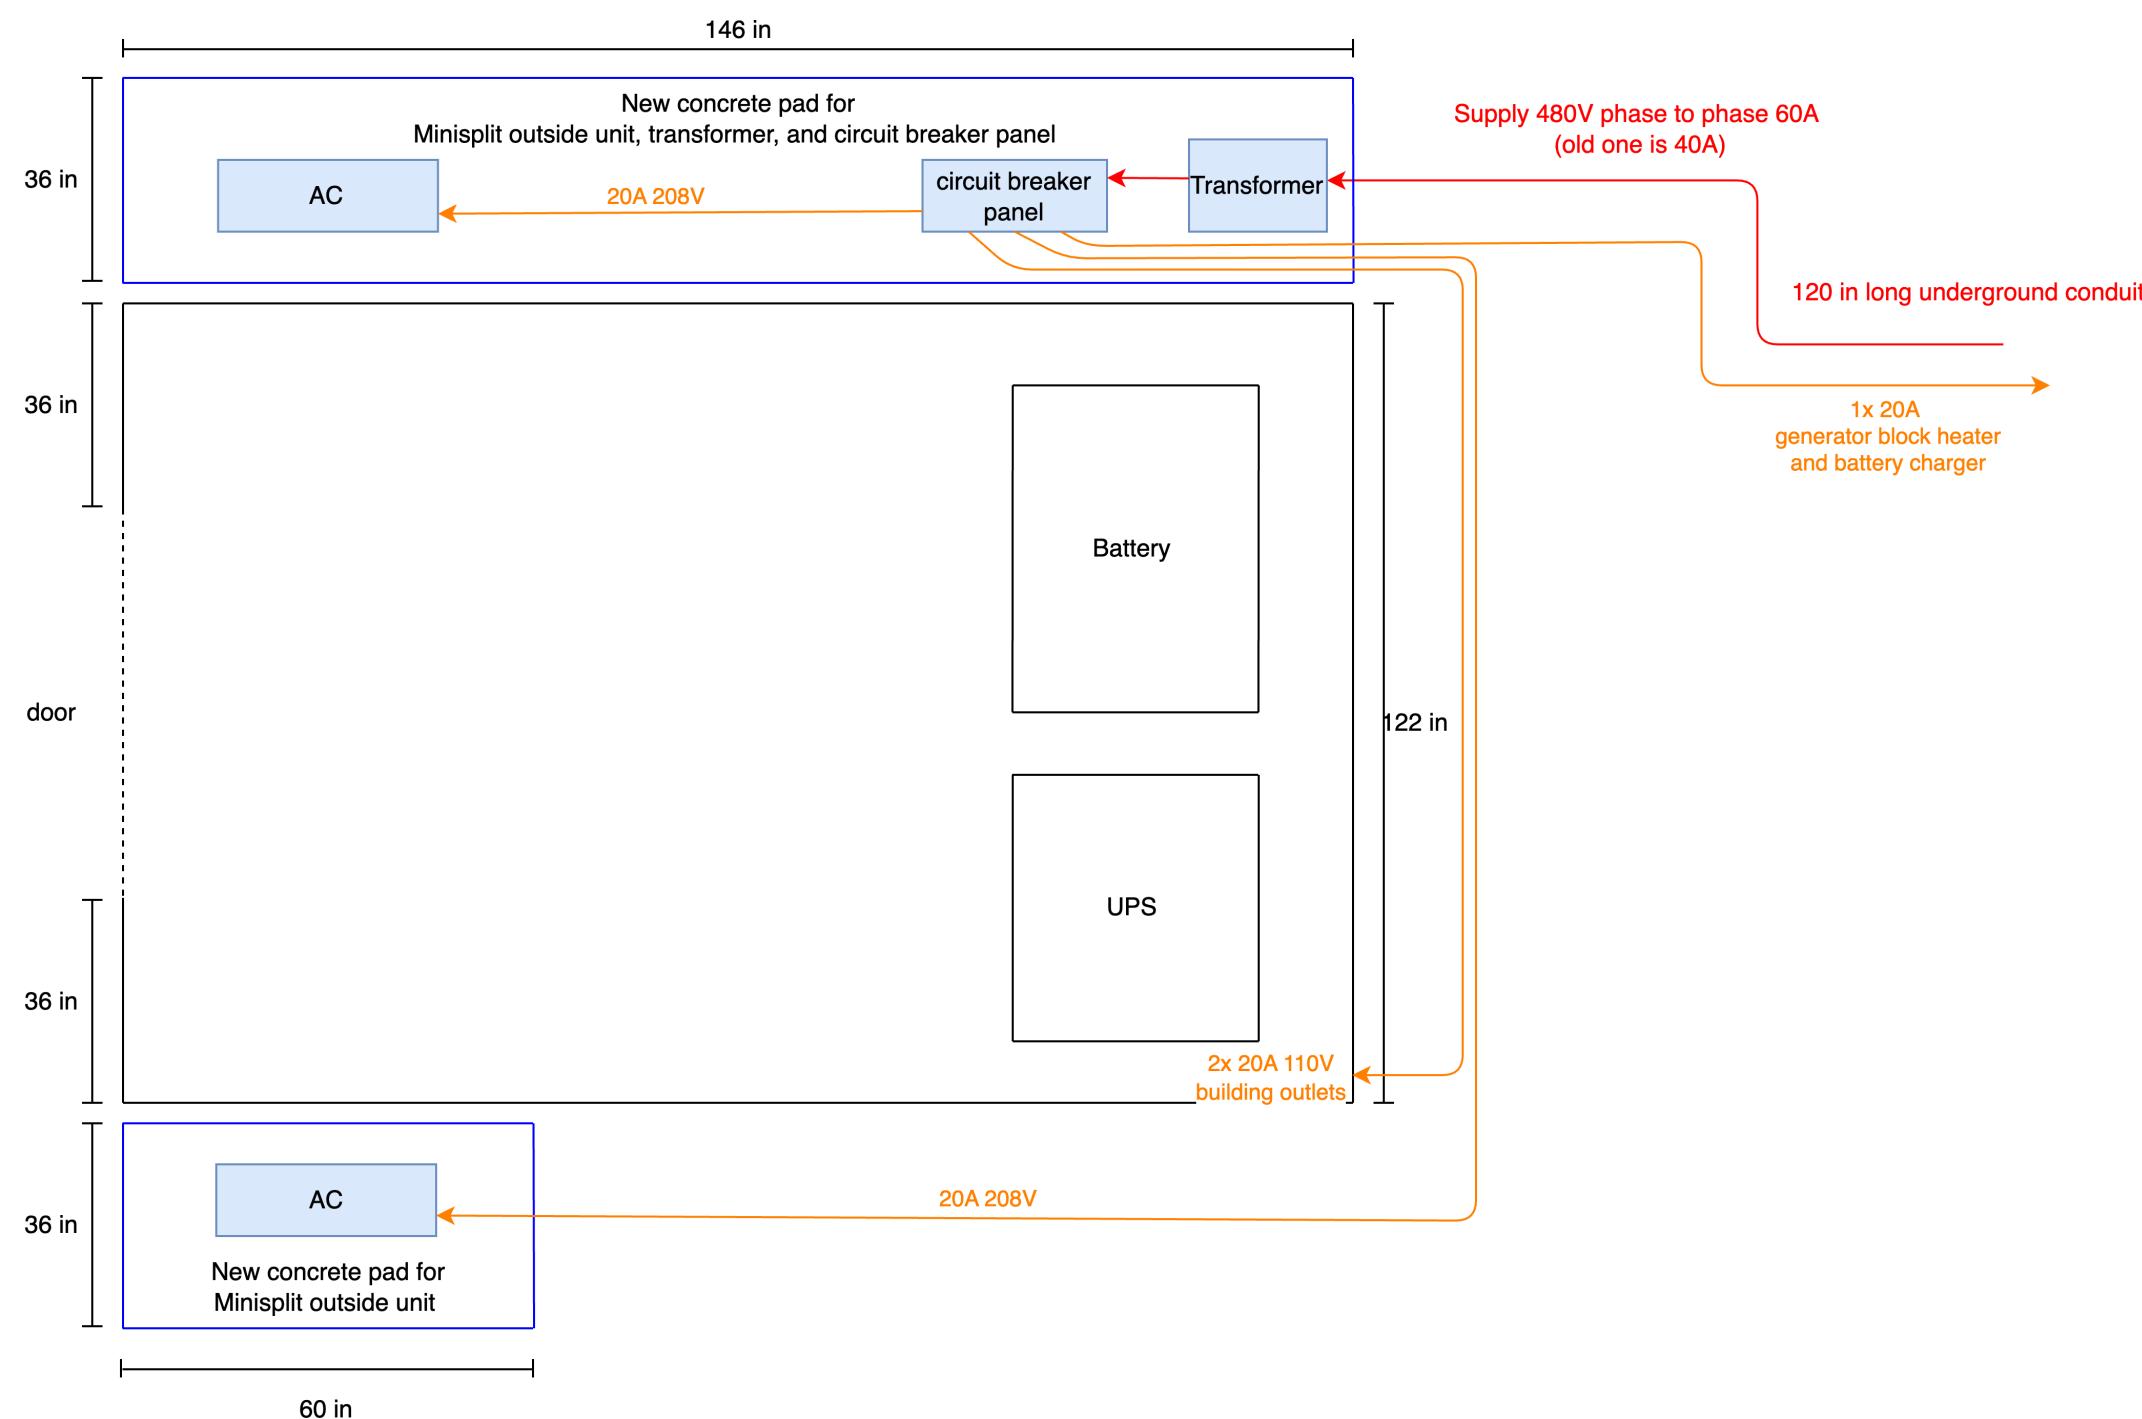

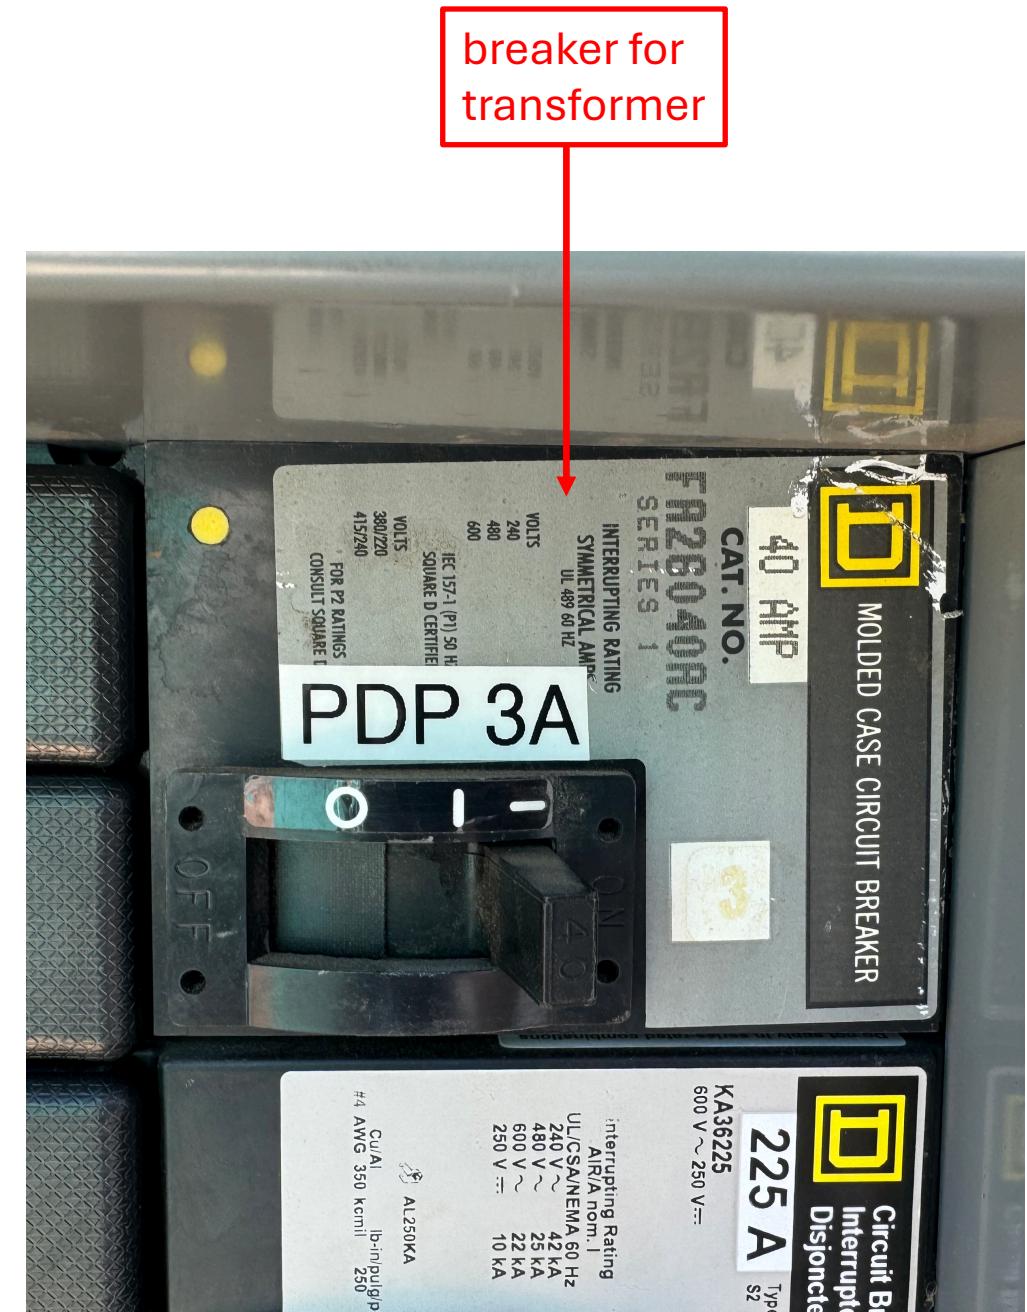

# Supply panel PDP-3

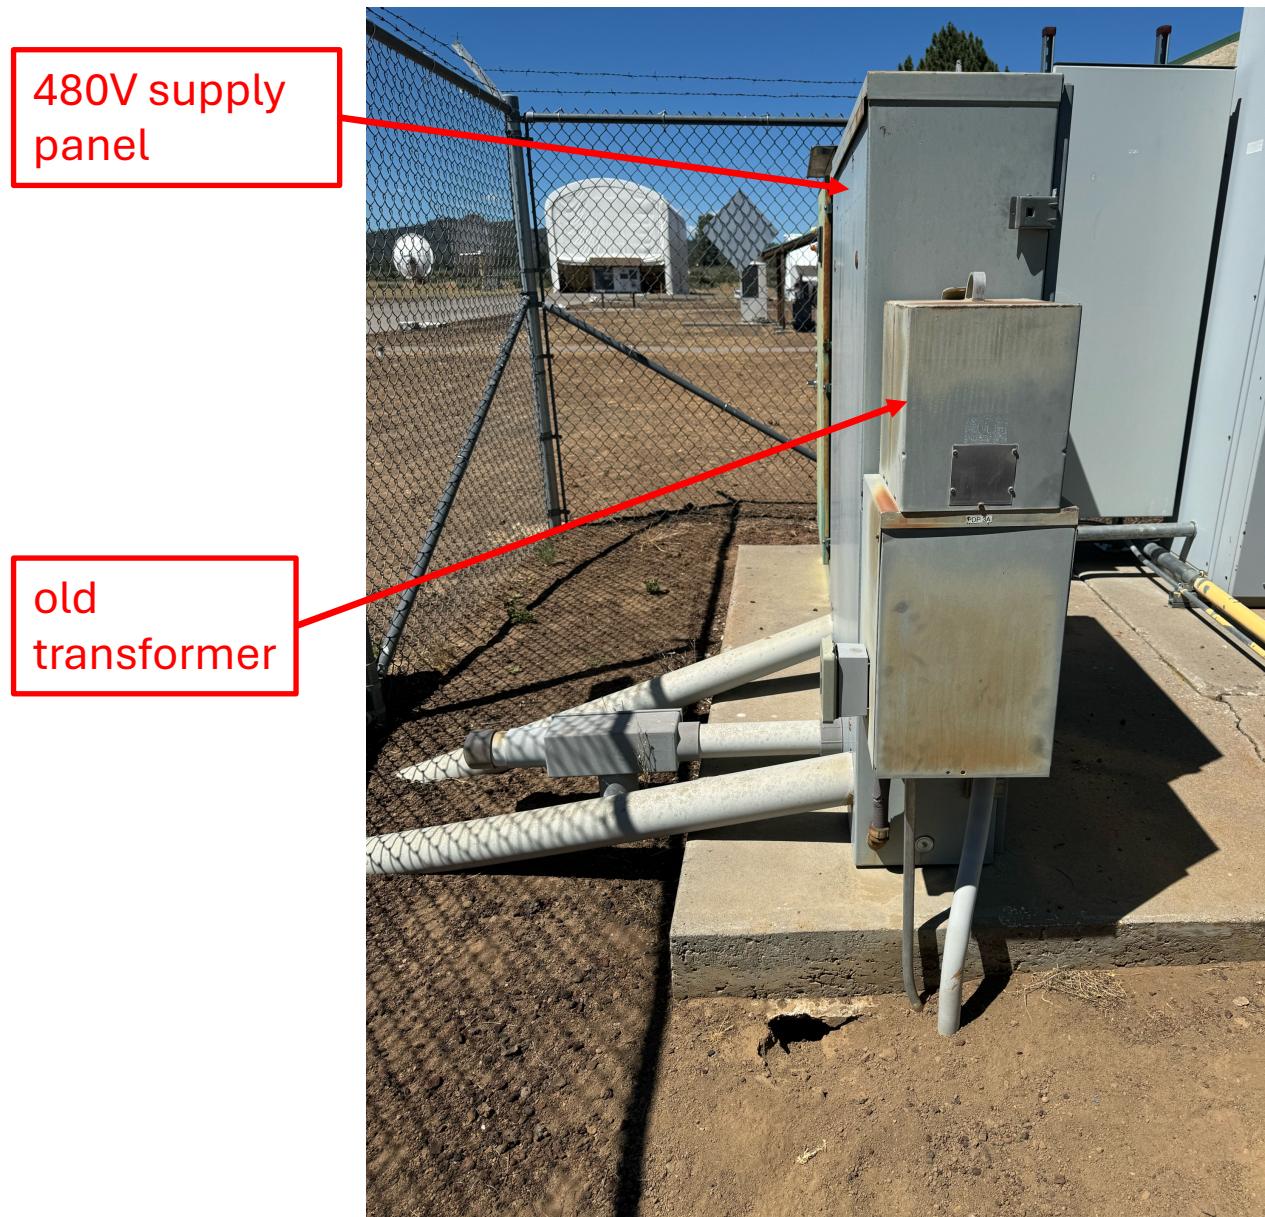

# HCRO main power distribution

As Built System  
August 2024

