




new concrete pad

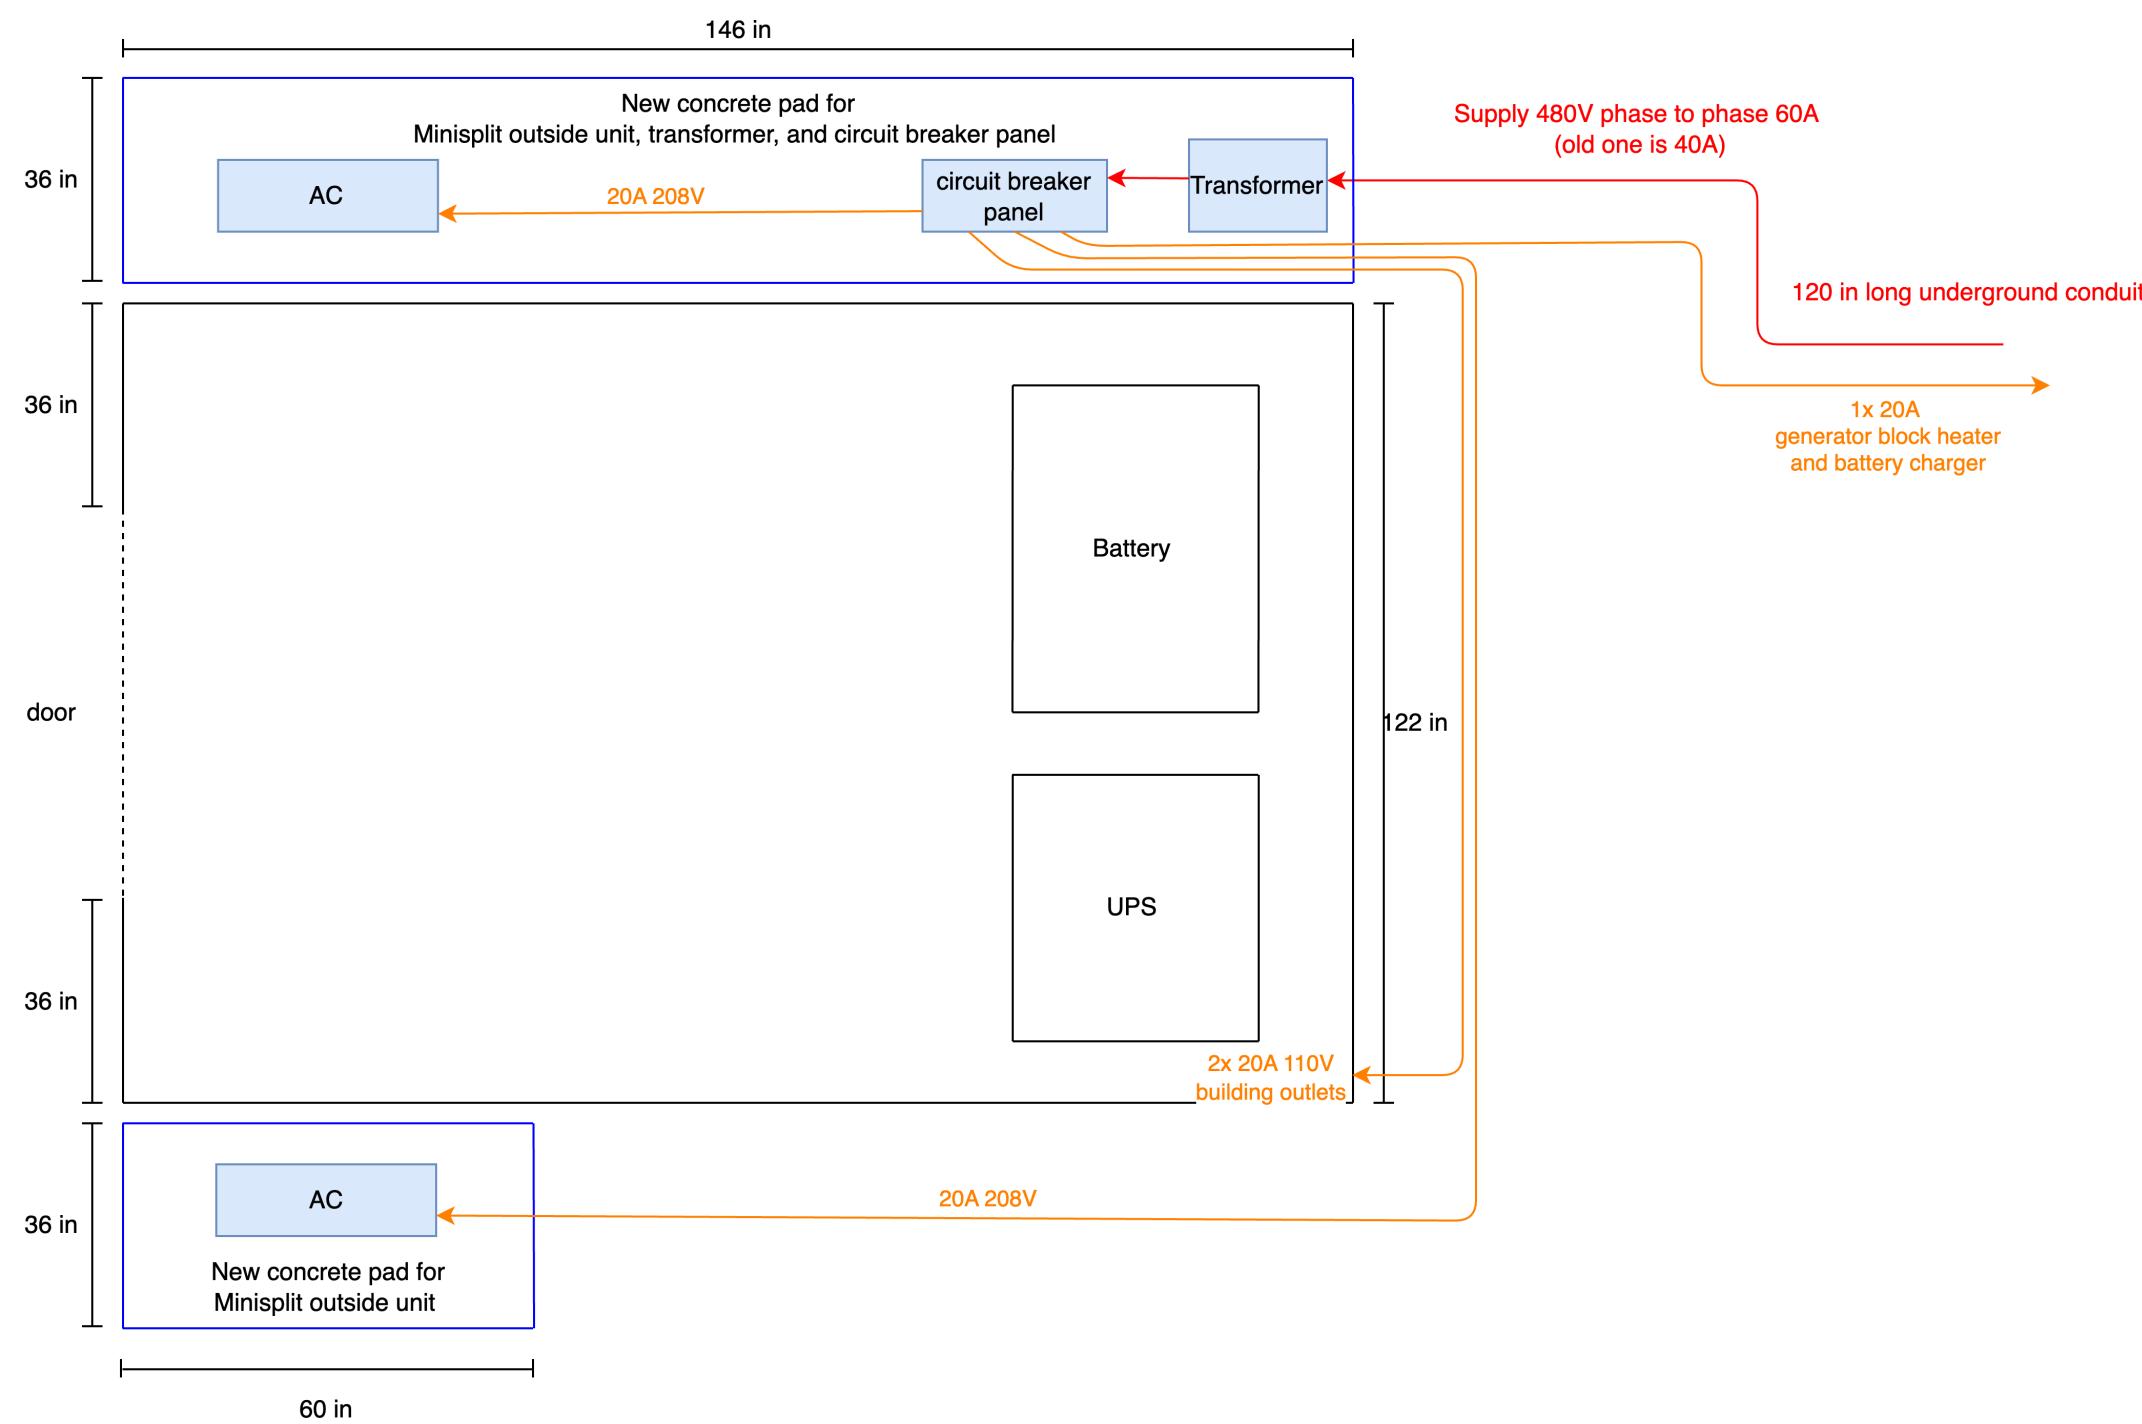

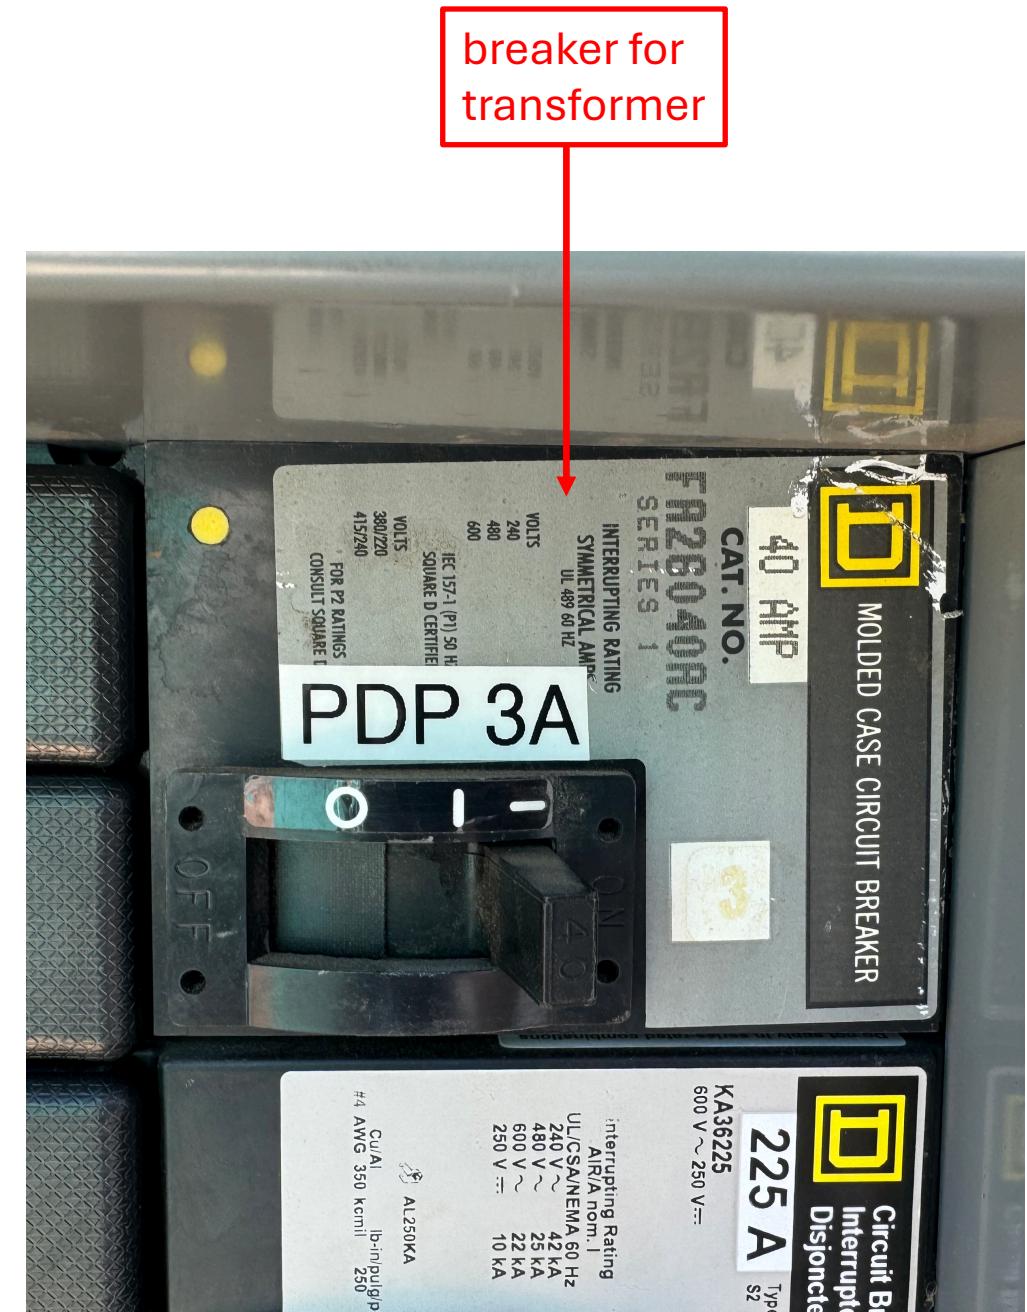

Supply panel PDP-3

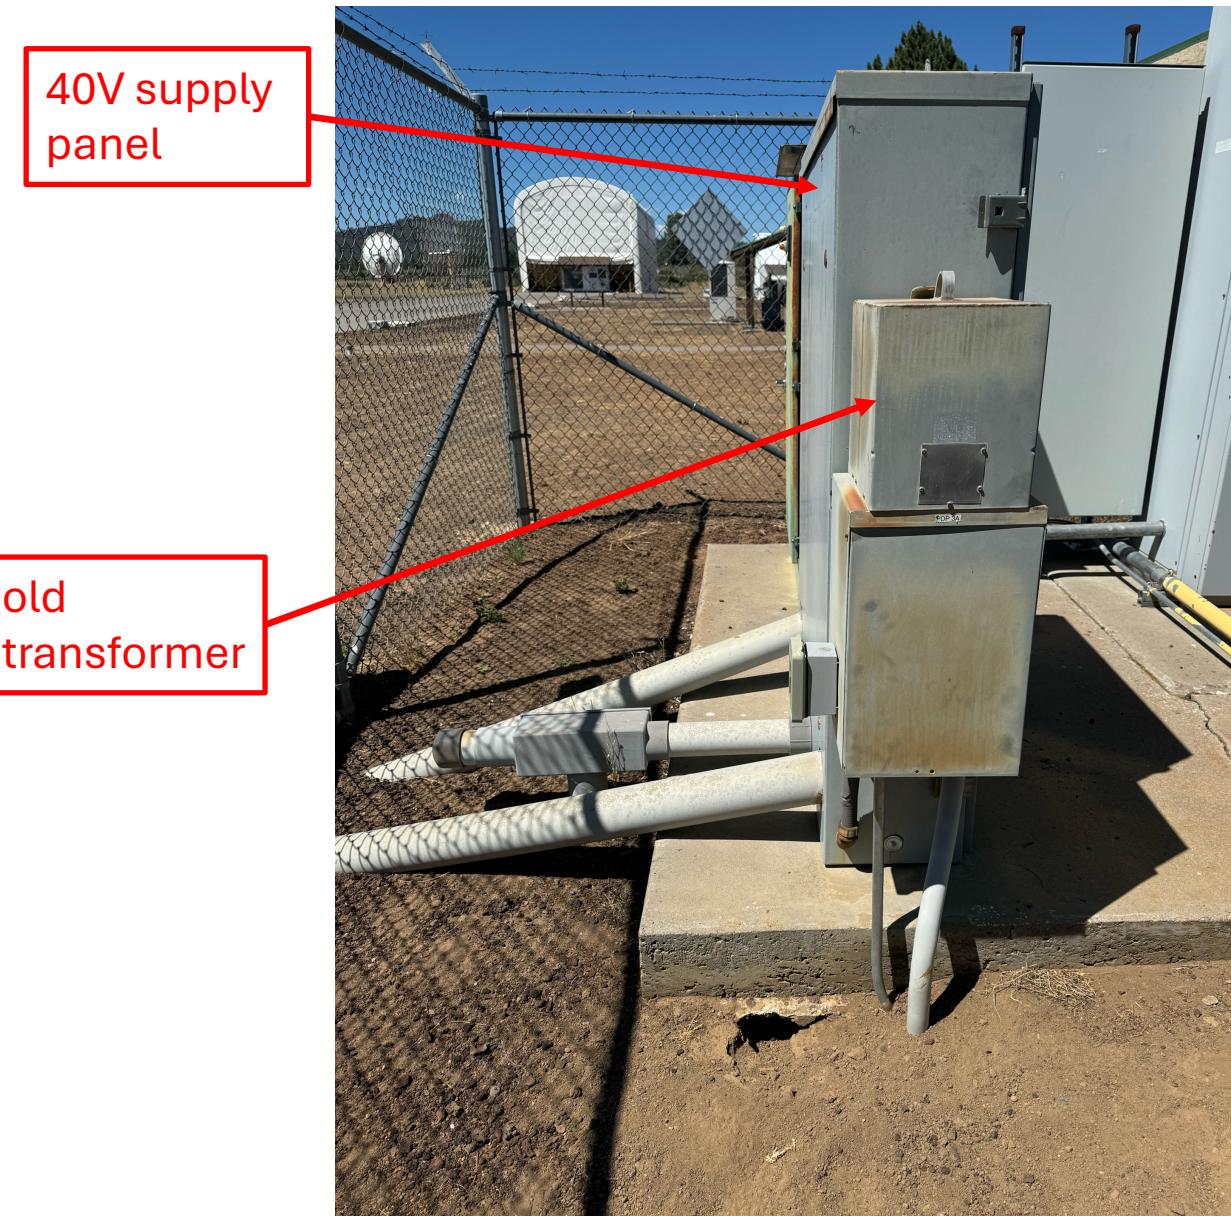

HCRO main power distribution

As Built System
August 2024

